




Giaveno (TO) - Borgata Balangero - Fog. 14 - Incendio del 30/01/2024




Foglio 39

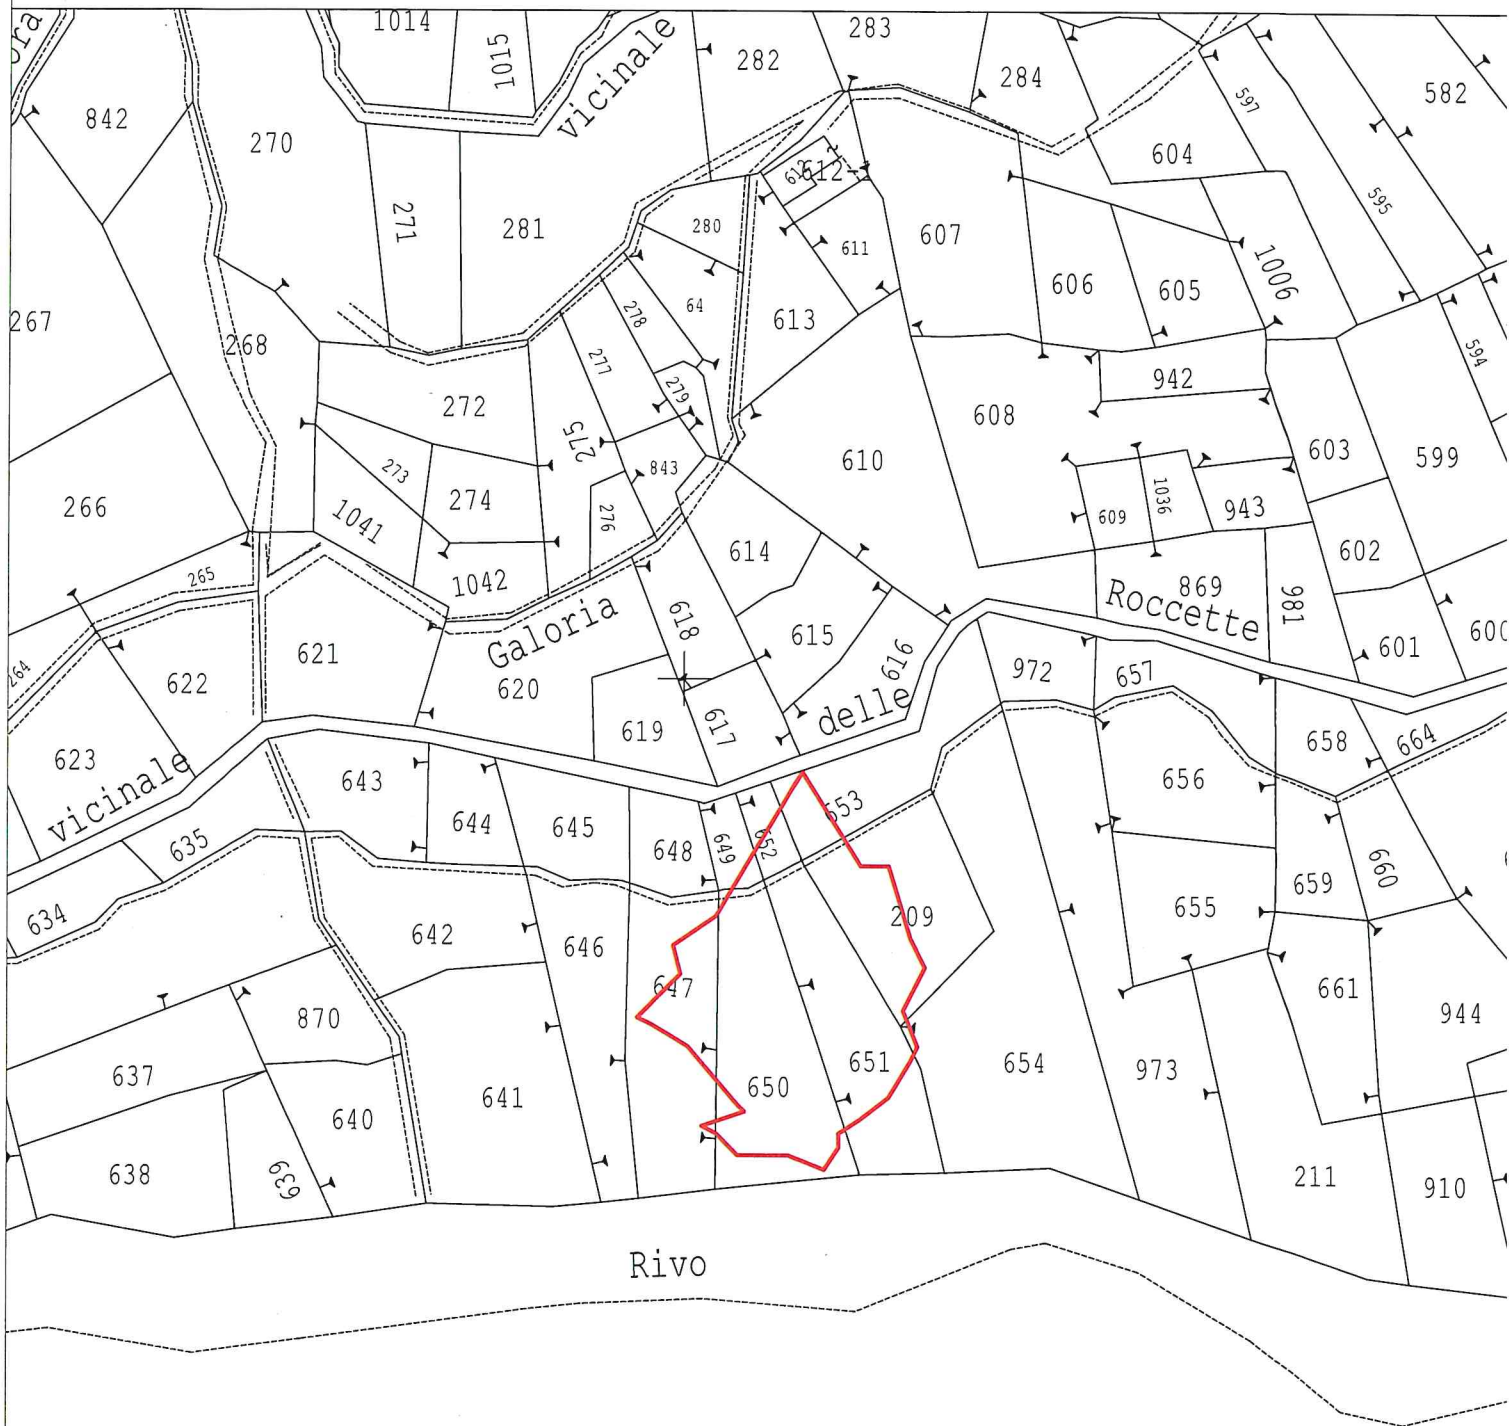

0 10 20 30 40 m

Scala 1: 1000

## This is a detailed cadastral map of a rural area, likely in a European country. The map is divided into numerous land parcels, each numbered. The numbers are distributed across the map, with some parcels having numbers in the 30s, 40s, 50s, 60s, 70s, 80s, 110s, 120s, and 130s. A prominent red line highlights a specific parcel boundary, which appears to be a small, irregularly shaped parcel located near the center-right of the map. The map also features several symbols: a cross symbol is located near the center, and a triangle symbol is located in the bottom-left corner. The map is surrounded by a black border, and there are some additional markings and lines indicating boundaries and features. The overall layout is a complex network of lines representing land parcels and their boundaries.

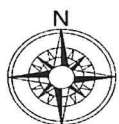

A horizontal line segment representing a 40m distance. It is divided into three parts by two vertical tick marks. The first part is labeled '10', the second part is labeled '20', and the third part is labeled '30'. The total length is labeled '40 m' at the right end.

*Materiale SIAN. Sono vietate la riproduzione e la divulgazione non autorizzate*

This is a detailed cadastral map of a rural area, likely in Italy, showing numerous land parcels with their respective numbers. A specific parcel, 381, is highlighted with a red border. The map includes various features such as roads, rivers, and a small building labeled "dei". The text "Foglio 41" is visible in the bottom right corner.


Parcel numbers visible on the map include: 780, 952, 781, 779, 782, 791, 812, 1075, 819, 820, 1082-1, 833, 831, 830, 827, 829, 831-1, 543, 537, 532, 549, 527, 505, 413, 411, 460, 523, 495, 494, 490, 482, 395, 386, 410, 994, 850, 849, 357, 845, 764, 761, 742, 741, 763, 355, 377, 739, 738, 743, 734, 740, 162, 760, 765, 759, 767, 1073, 880, 784, 789, 786, 787, 1025, 1024-1, 1025-1, 814-1, 814, 815-1, 815-2, 324, 844-1, 844, 843, 842, 136, 13



*Materiale SIAN. Sono vietate la riproduzione e la divulgazione non autorizzate*





**GIAVENO (TO) - Borgata Polatera - Fog. 39 - Incendio boschivo del 6/2/2024**

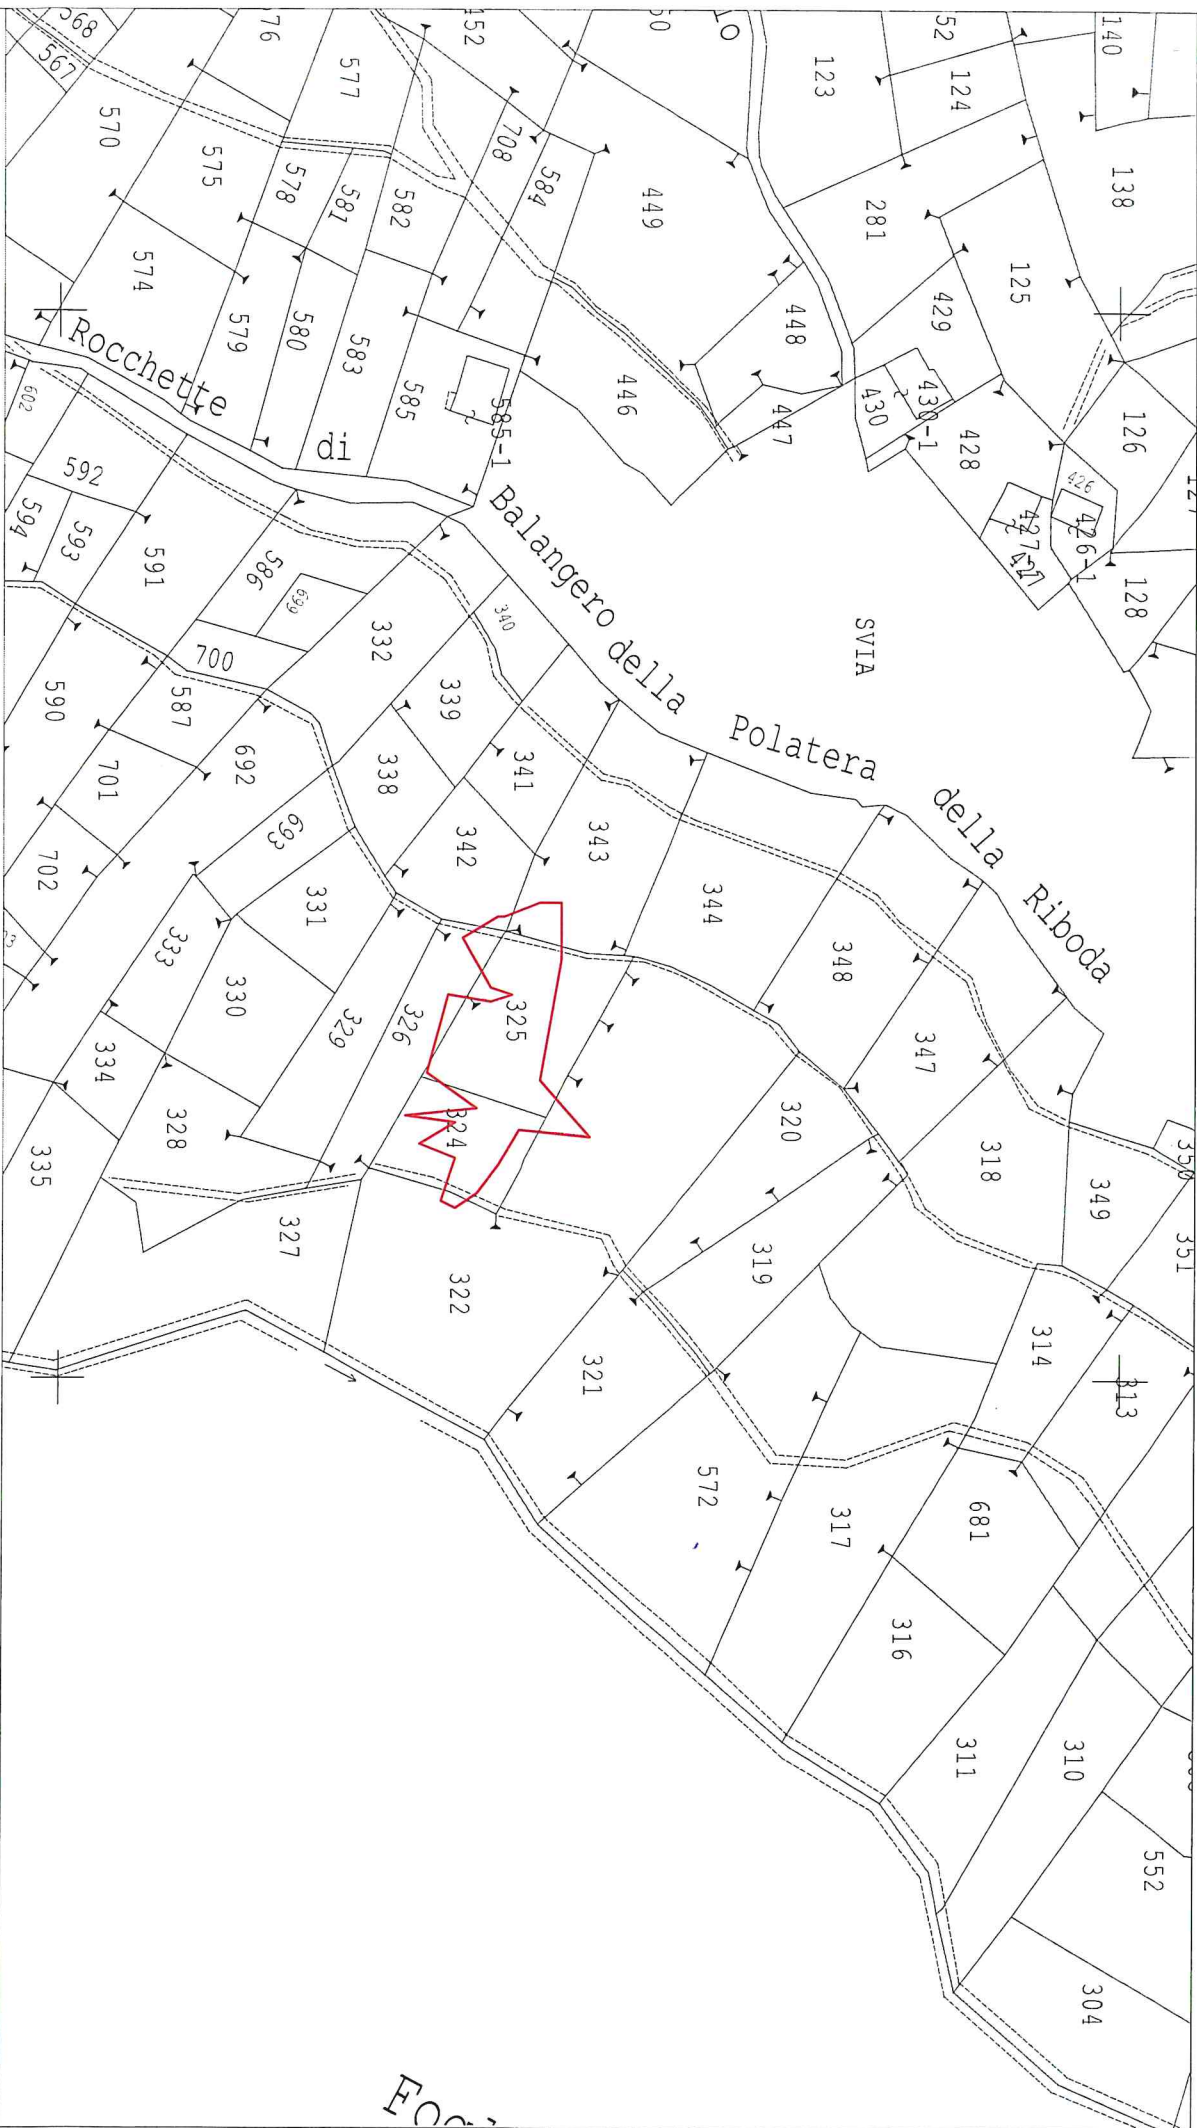


Scala 1 : 1000

## Giaveno (TO) - Borgata Roccette - Fog. 13 - Incendio del 19/02/2024

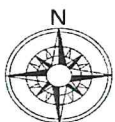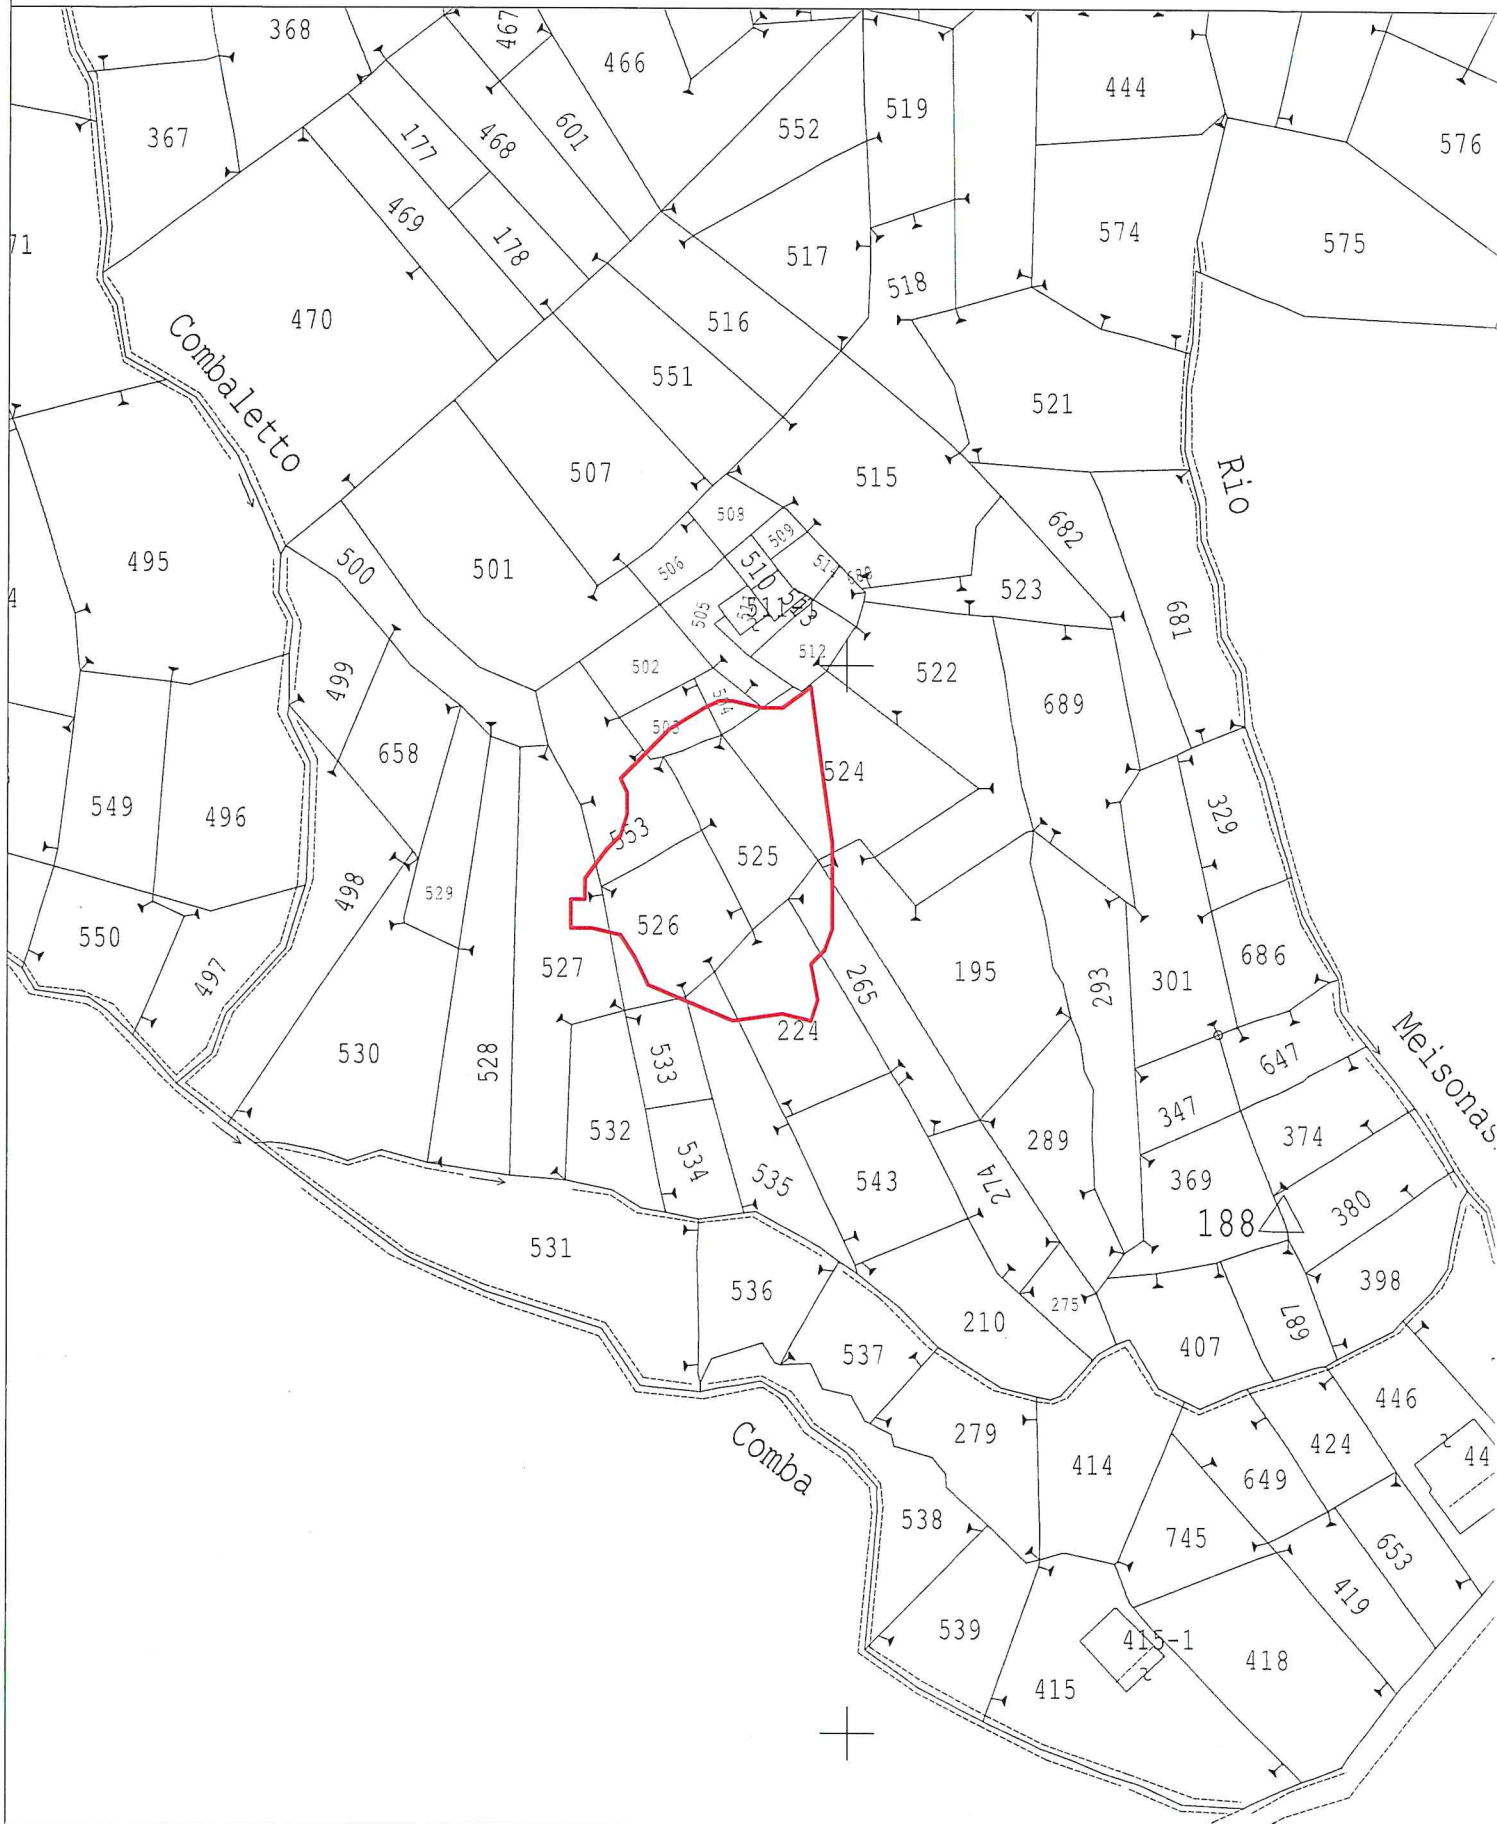

0 10 20 30 40 m




Scala 1: 1000

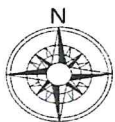

*Materiale SIAN. Sono vietate la riproduzione e la divulgazione non autorizzate*




**Incendio Boschivo del 22/02/2024 - Comune: Gaiaveno (TO) - Borgata Polatera - Fog. 39**

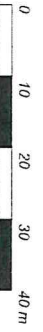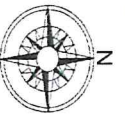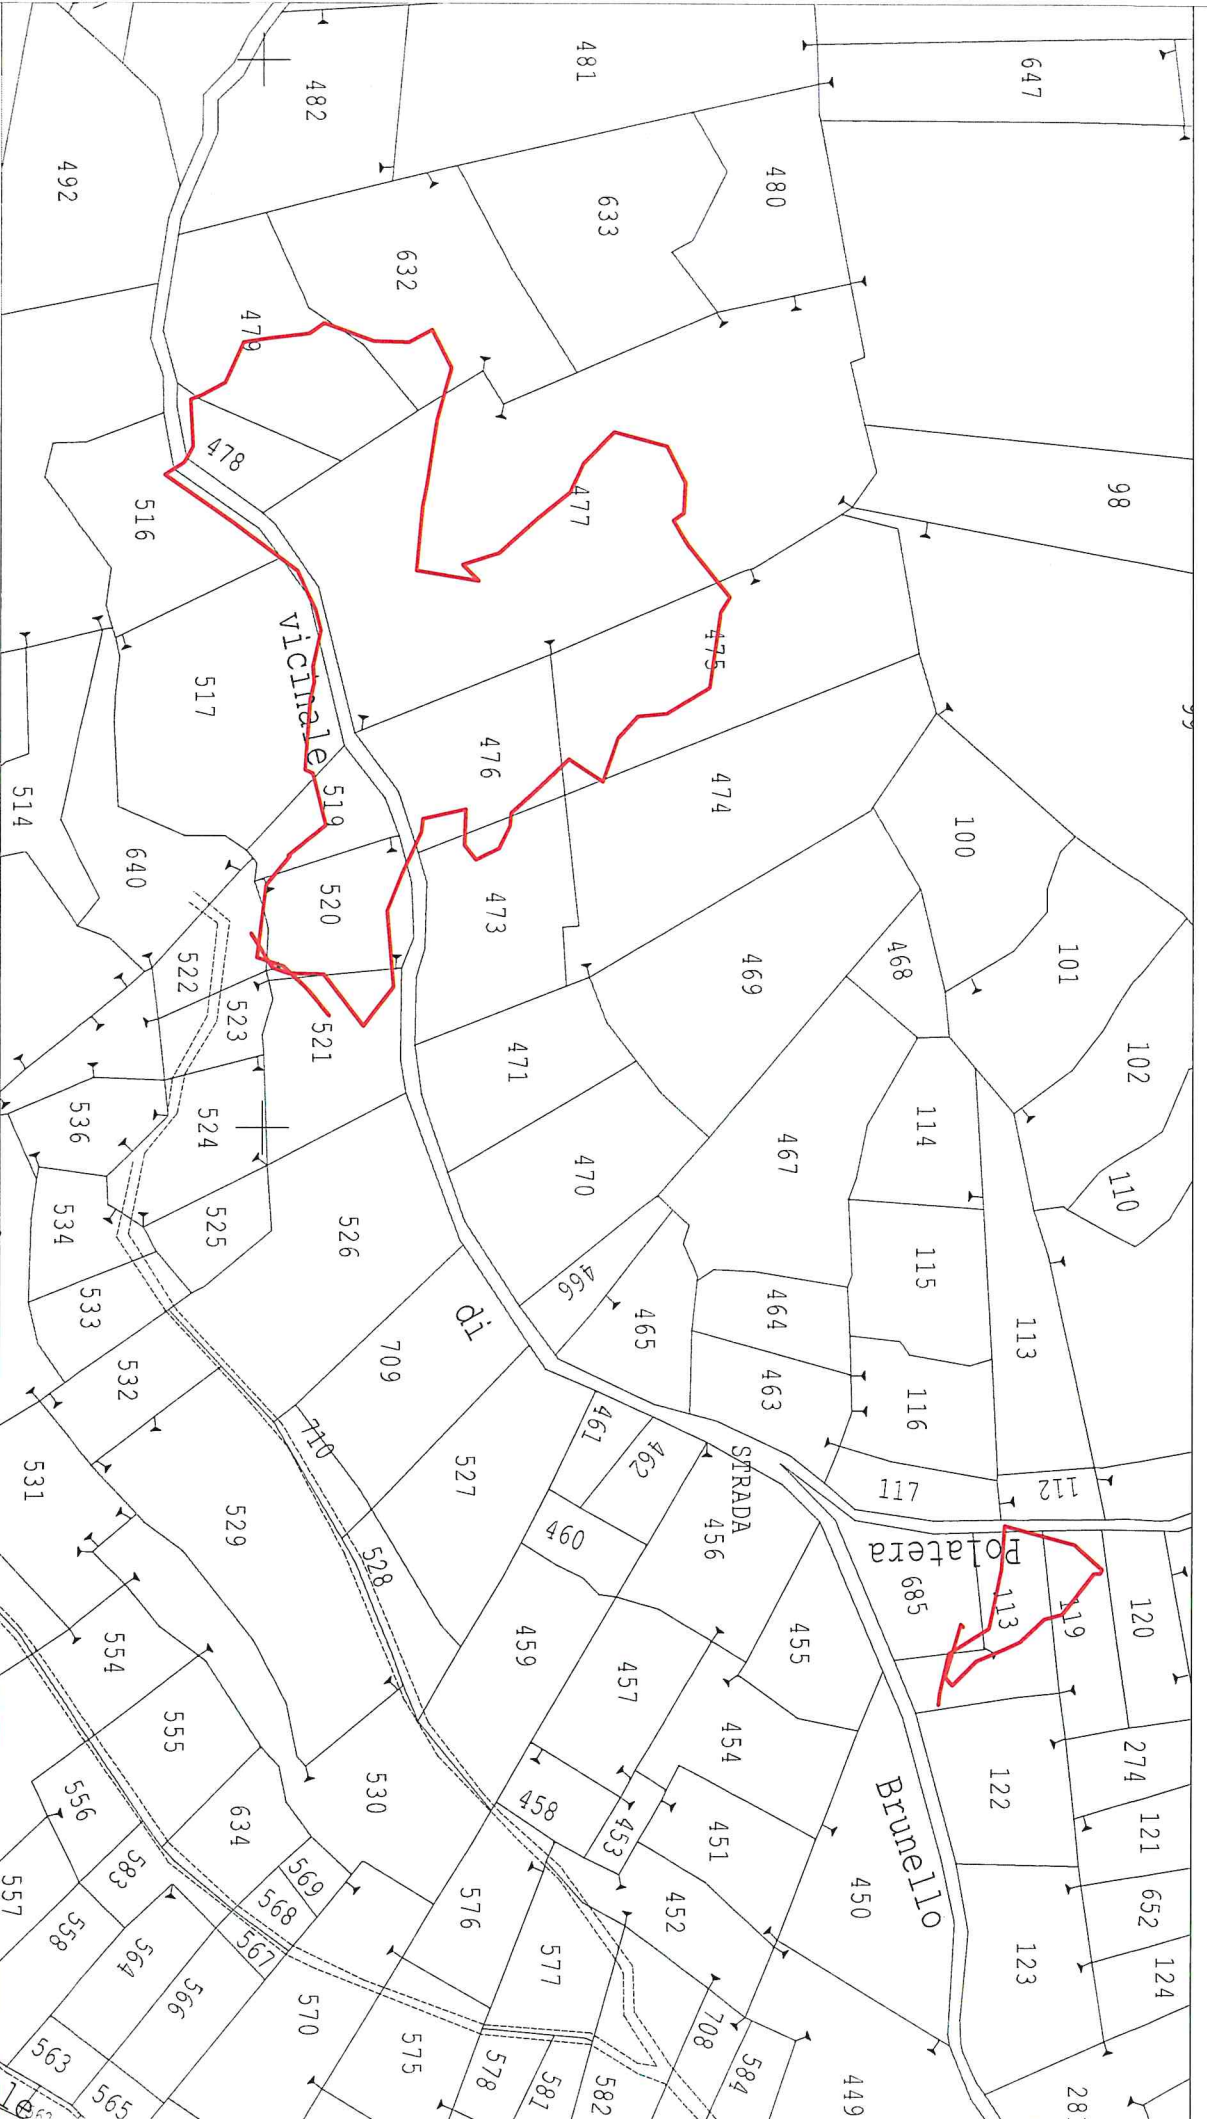

Scala 1: 1000

*Incendio Boschivo del 22/02/2024 - Comune: Giaveno (TO) - Borgata Polatera - Fog. 39*

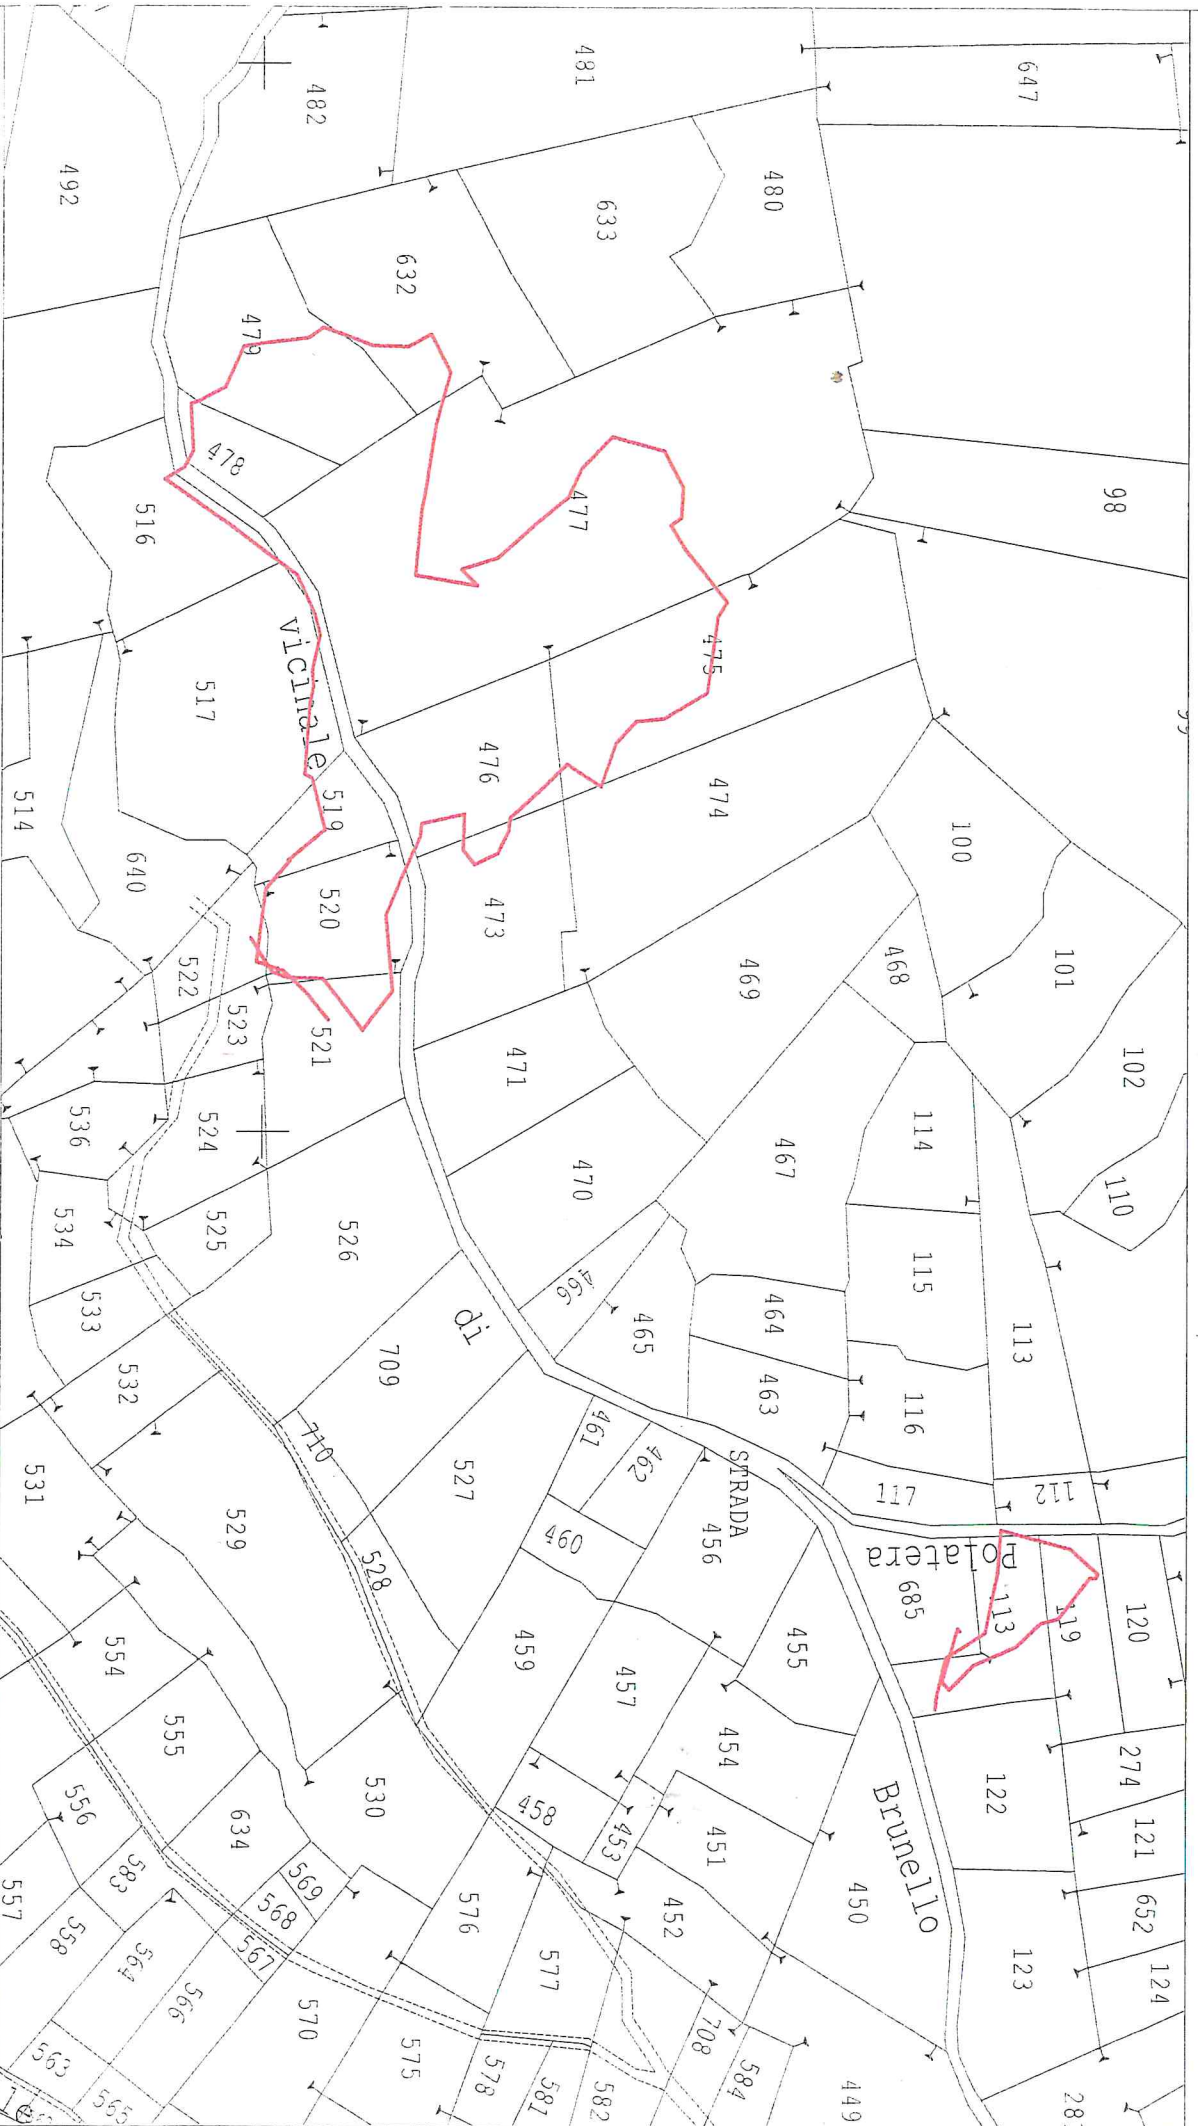

Scala 1: 1000





Scala 1: 2000